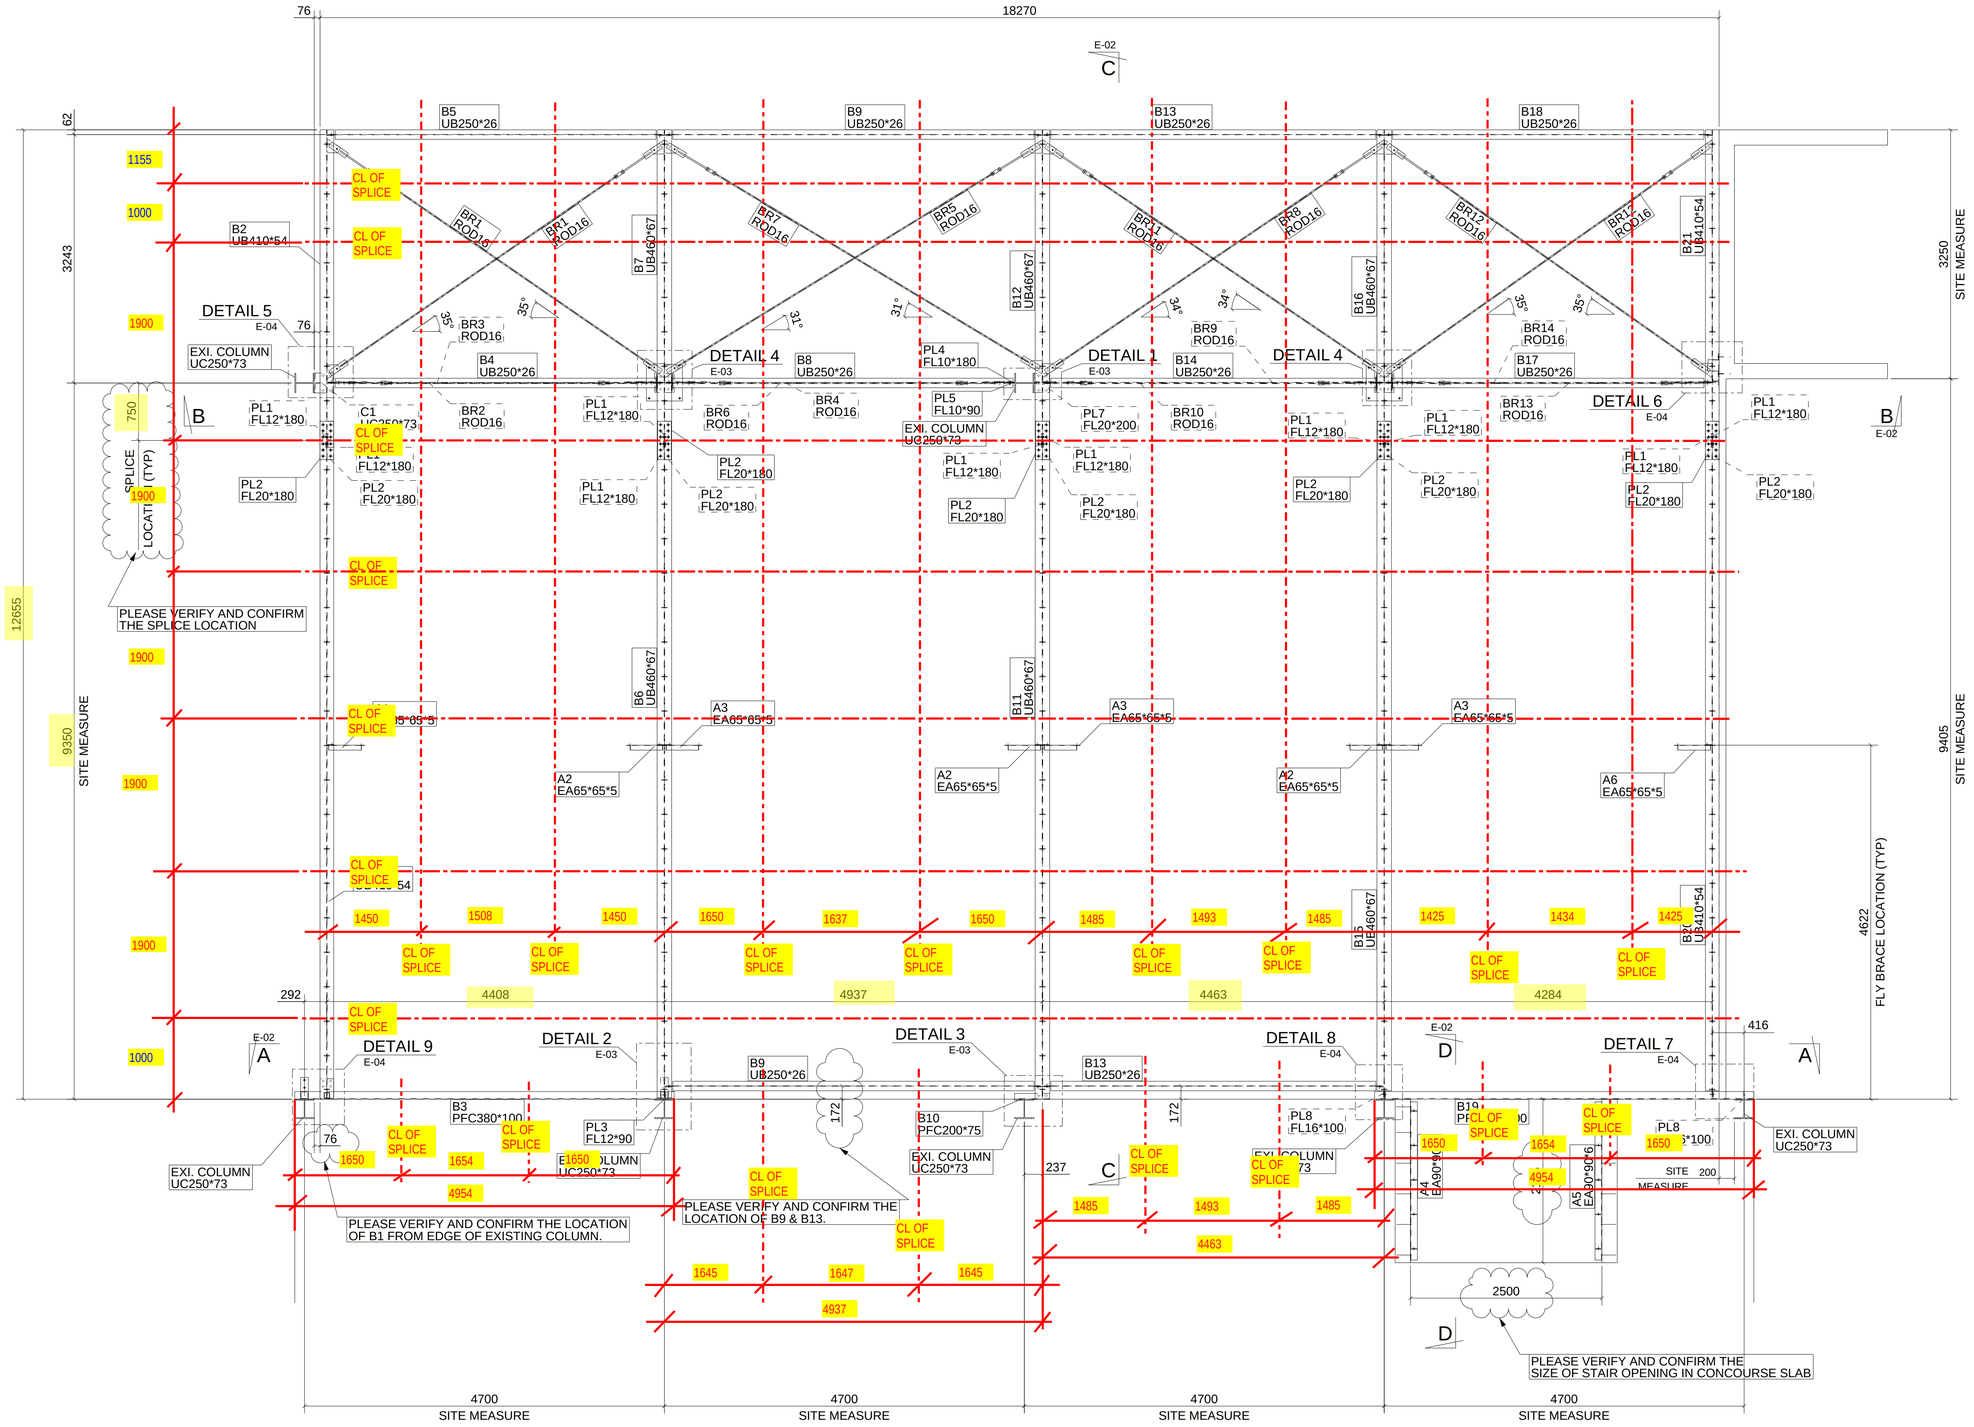

FLOOR PLAN (PLAN @ RL+0.00)

TEK1: APPROVER PLEASE VERIFY AND CONFIRM THE BEAM SPLICE LOCATION WHICH IS LAYOUT BY AS PER ERECTABILITY LENGTH OF 1900mm.

REV	DATE	DESCRIPTION
A	11.02.2020	ISSUED FOR APPROVAL - NOT FOR CONSTRUCTION

GENERAL NOTES :

1. ALL HORIZONTAL MEMBERS HAVE ASSEMBLY MARK STAMPED ON NORTH OR WEST END AND ON TOP SURFACE
2. ALL COLUMNS HAVE ASSEMBLY MARK STAMPED ON NORTH OR WEST FACING FLANGE NEAR BASE OF SHAFT
3. FIN PLATES FOR CHANNELS ARE ON OUTSIDE WEB FACE ON HEEL UNO
4. FIN PLATES FOR BEAMS WILL BE ON THE NORTH OR WEST SIDE OF BEAM WEB UNO. ie. ERECT BEAMS TO SOUTH OR EAST SIDE OF FIN PLATE

CLIENT:

OSE RIGGERS

PERTH AIRPORT T4 UNIT 11 & 12

Tek1 Pty Ltd

Steel Detailing
Design, Engineering

19 Tulloch Grove, Glen Waverly 3150
Phone: 03 95606397
www.tek1.com.au

These designs, plans and specifications and the copyright therein are the property of Tek1 Pty Ltd and must not be used, reproduced or copied wholly or in part without the written permission of Tek1 Pty Ltd.

PERTH AIRPORT T4 UNIT 11 & 12 FLOOR PLAN

DRAWN		SCALE	NTS	JOB No.	DRAWING NUMBER	REV
CHECKED		DATE	06.02.2020	Q1295	E-01	A